


FLORENCE REGIONAL SEWER DISTRICT MARKLAND AND SEWER EXTENSION

FLORENCE REGIONAL SEWER DISTRICT

ROBERT WHEELER, President
LARRY STEWART, Vice President
PATRICIA CHASE, Secretary/Treasurer
ART ADAMS
JACK KIDWELL

APPROVED:

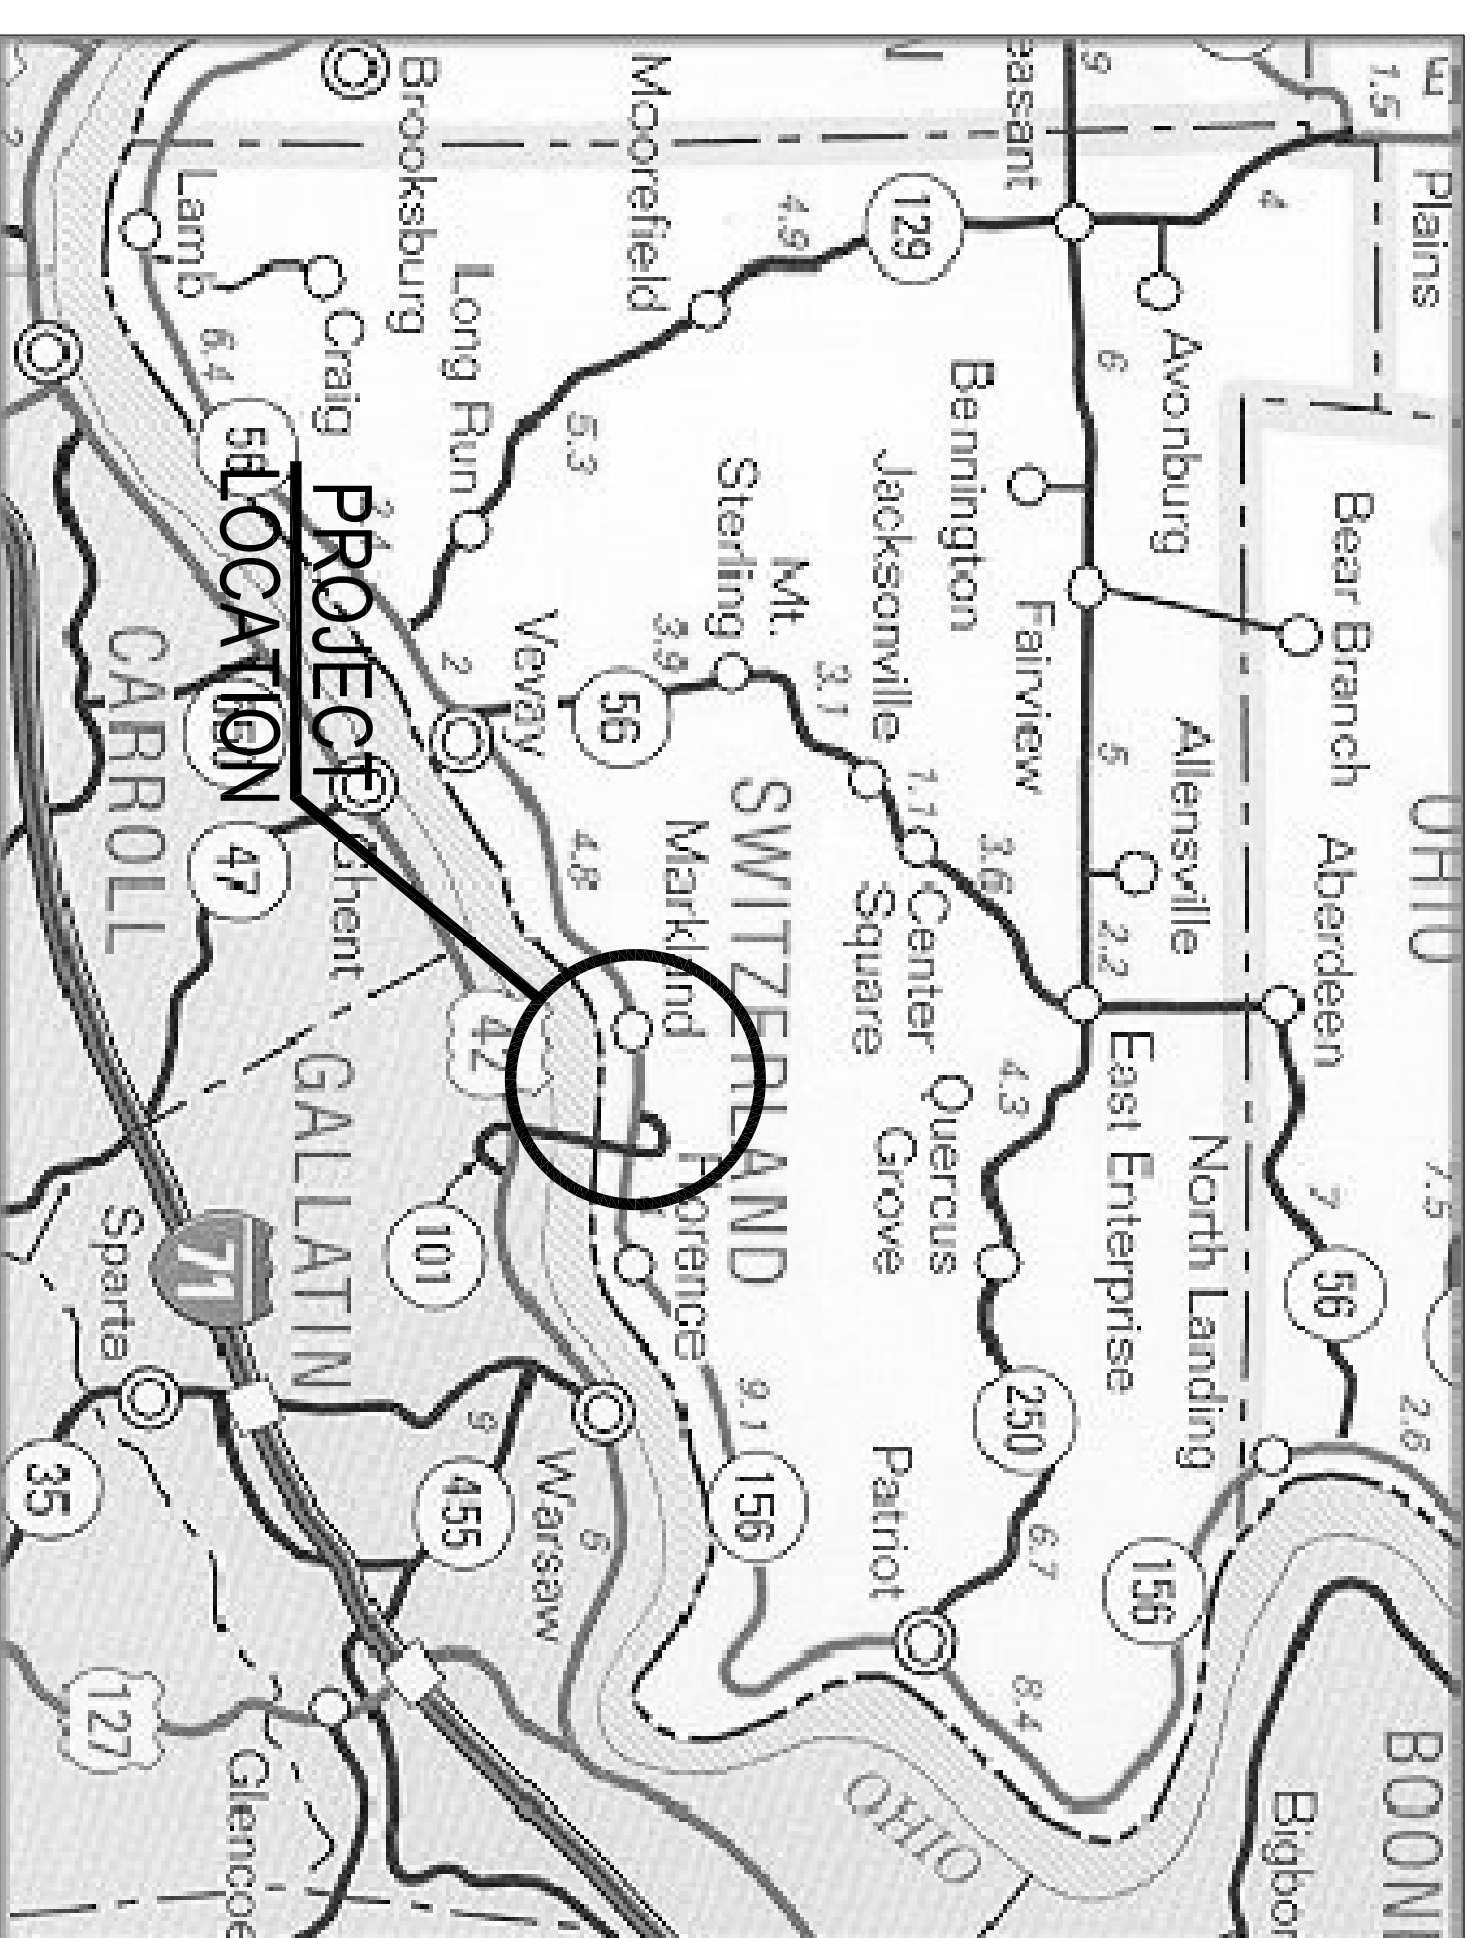


*Markland Sewer Extension
Town of Markland
Switzerland Co., Indiana*

INDEX

DESCRIPTION	SHEET #
Title & Index	1
Plan & Profile - Line 1.00 & 2.00	2
Plan & Profile - Line 3.00	3
Plan & Profile - Line 4.00	4
Plan - Force Main	5
Lift Station Details	6

HOWARD J. BARTH & ASSOCIATES

ENGINEERS - DESIGNERS
347 E. Washington Street
Greensburg, Indiana 47240

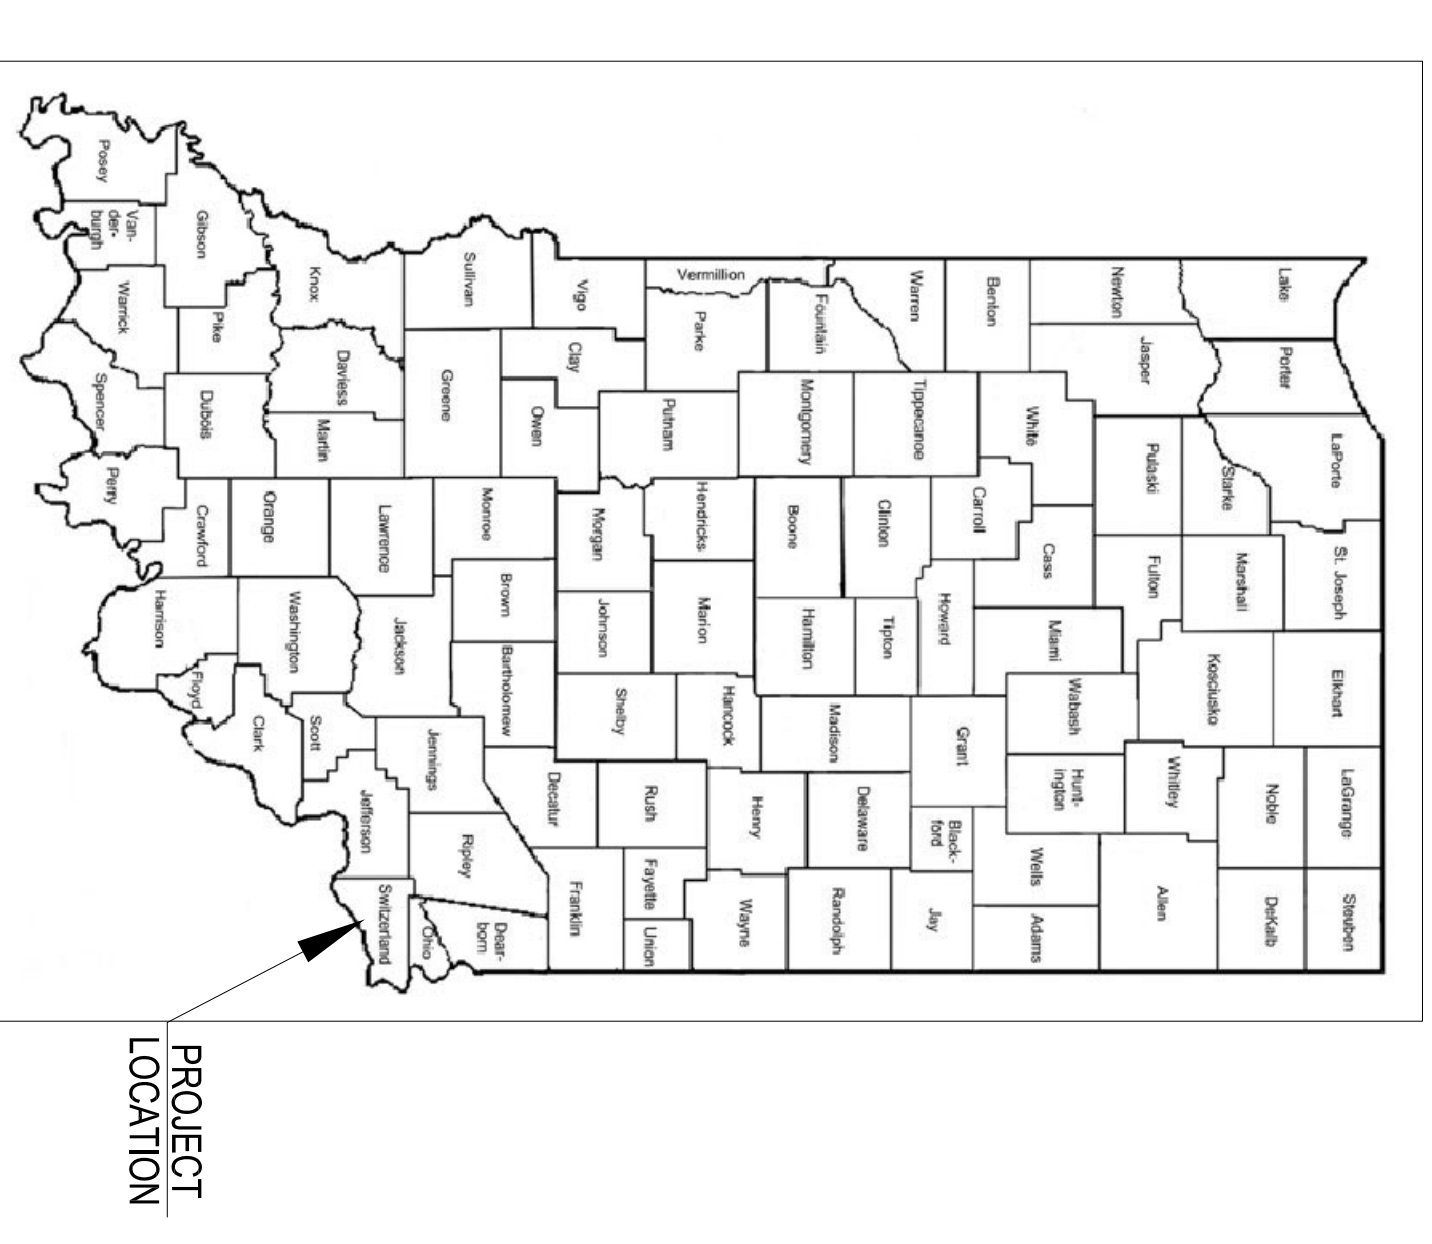

RECORD DRAWINGS
These Record documents have been prepared based on information provided by others. The Design Professional has not verified the accuracy and/or completeness of this information and shall not be responsible for any errors or omissions which may be incorporated herein as a result.

