


PLAN - FORCE MAIN

SCALE: 1"=50'


- LEGEND**
- ⊗ AIR RELIEF VALVE
 - ⊗ PLUG VALVE and BOX

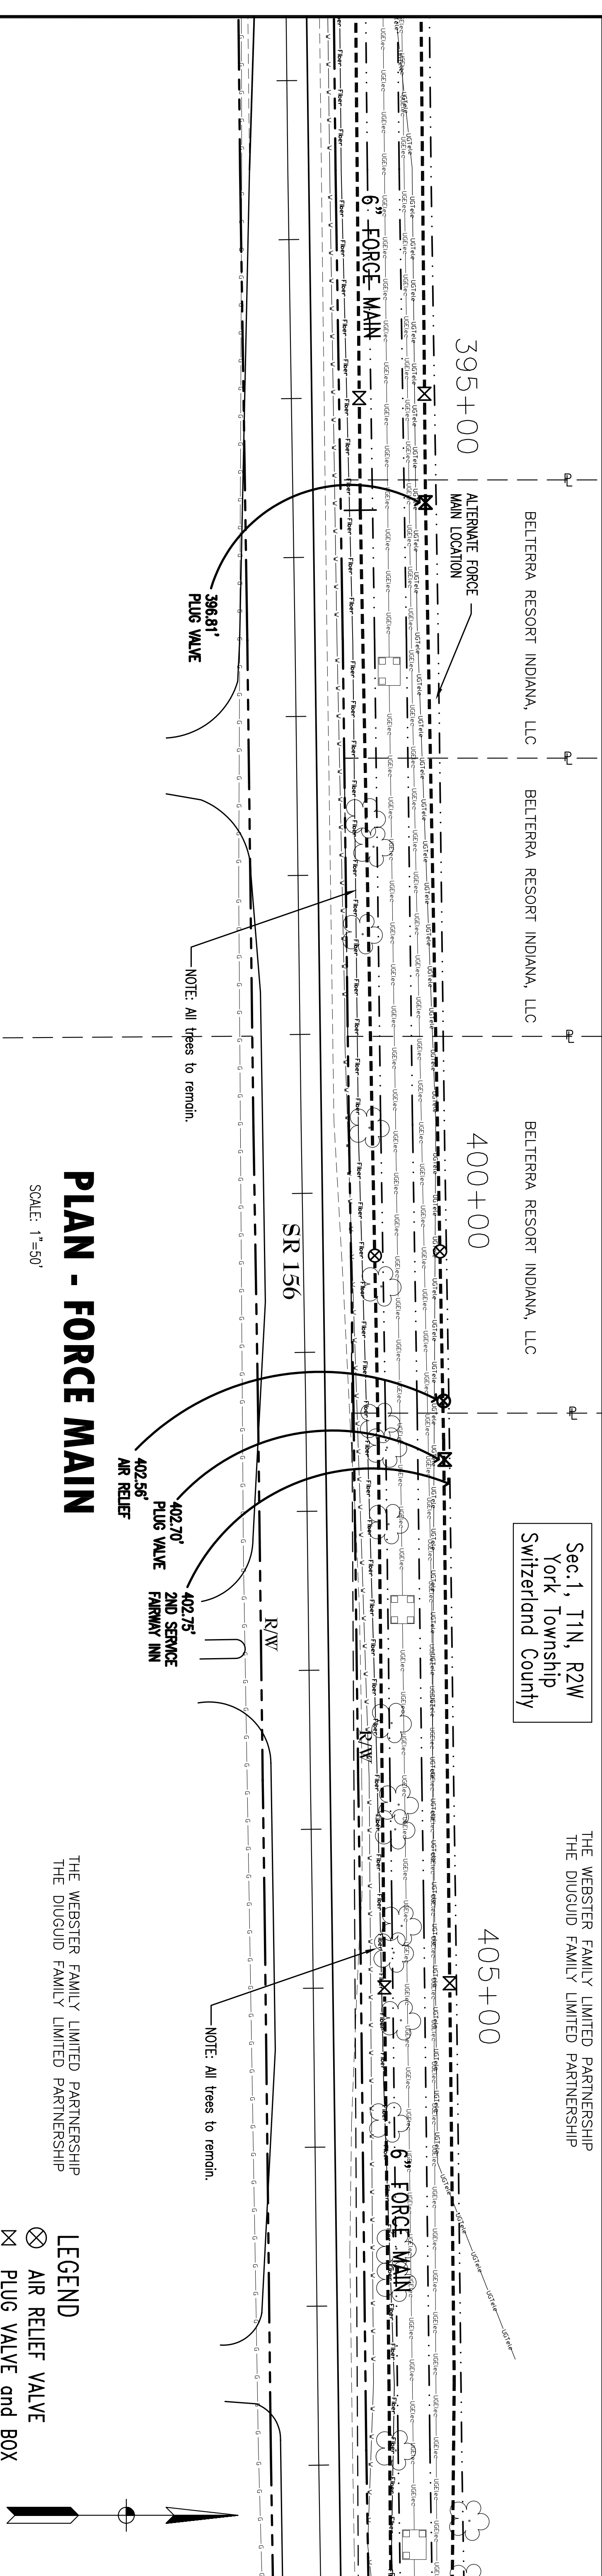

PLAN - FORCE MAIN

SCALE: 1"=50'

- LEGEND**
- ⊗ AIR RELIEF VALVE
 - ⊗ PLUG VALVE and BOX

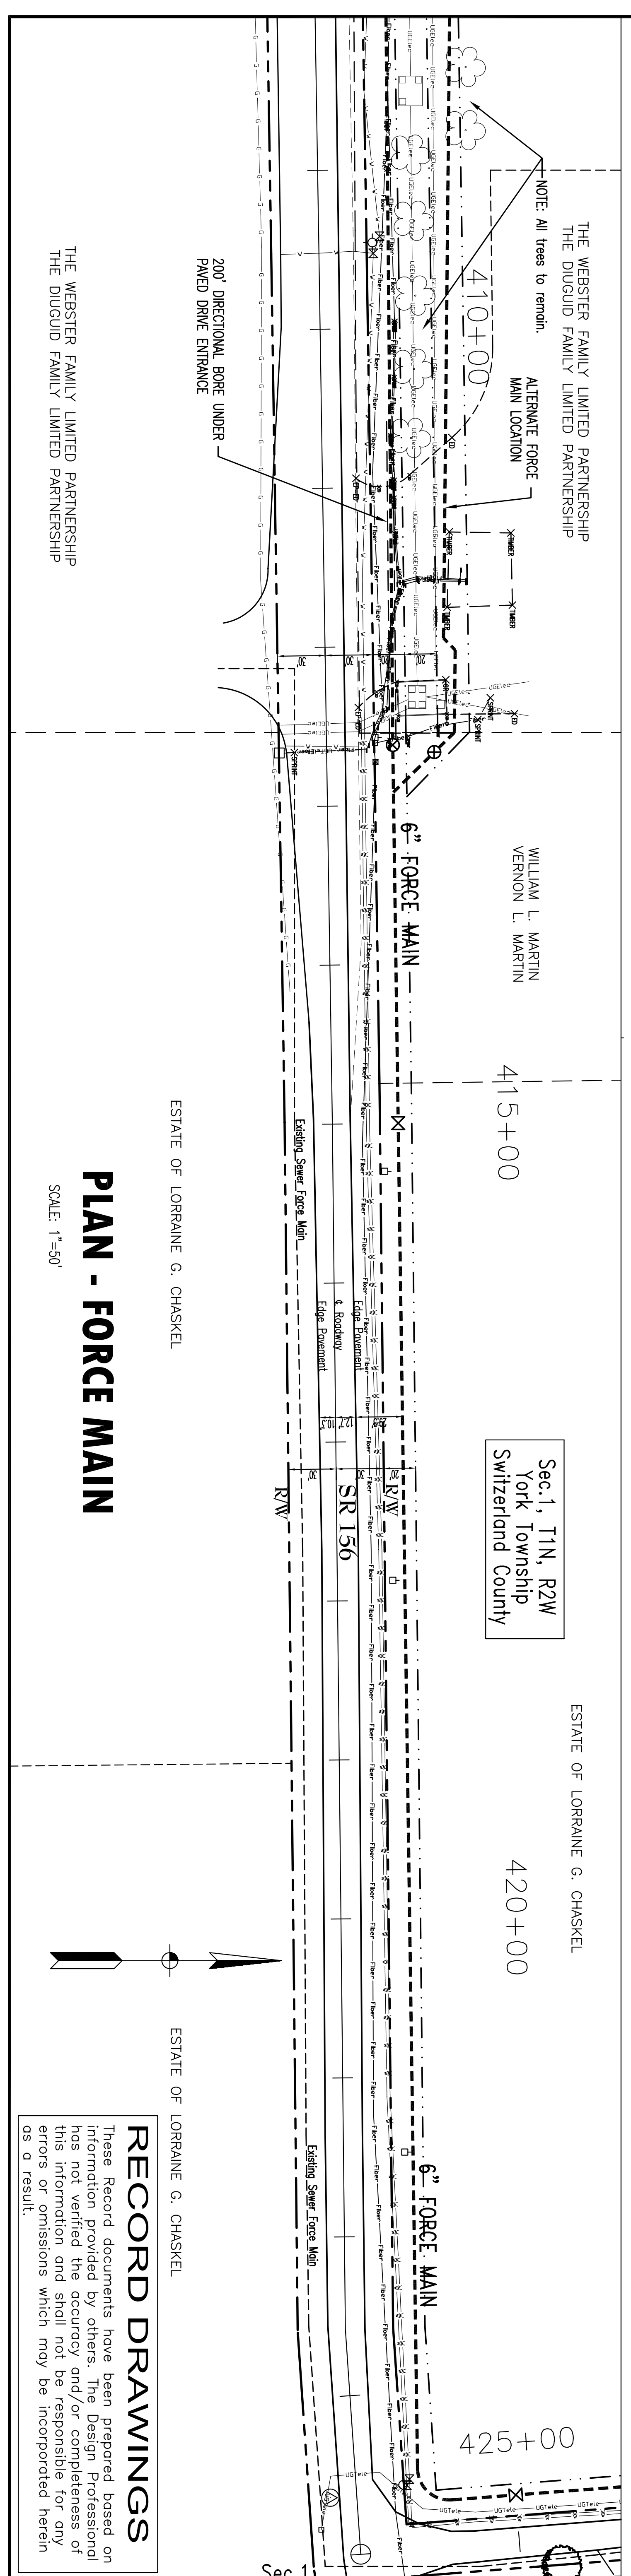

PLAN - FORCE MAIN

SCALE: 1"=50'

RECORD DRAWINGS

These Record documents have been prepared based on information provided by others. The Design Professional has not verified the accuracy and/or completeness of this information and shall not be responsible for any errors or omissions which may be incorporated herein as a result.

Sec. 1, T1N, R2W
York Township
Switzerland County

BELTERRA RESORT INDIANA, LLC

Sec. 1, T1N, R2W
York Township
Switzerland County

THE WEBSTER FAMILY LIMITED PARTNERSHIP
THE DIUGUID FAMILY LIMITED PARTNERSHIP

BELTERRA RESORT INDIANA, LLC

Sec. 1, T1N, R2W
York Township
Switzerland County

ESTATE OF LORRAINE G. CHASKEL

ESTATE OF LORRAINE G. CHASKEL

ESTATE OF LORRAINE G. CHASKEL

RECORD DRAWINGS

These Record documents have been prepared based on information provided by others. The Design Professional has not verified the accuracy and/or completeness of this information and shall not be responsible for any errors or omissions which may be incorporated herein as a result.

FORCE MAIN

Florence Regional Sewer District
Town of Florence, Indiana


JOB NO	01-2748
DWN BY	brk
CHK BY	jjg
DATE	4/02
SCALE	1"=50'

NO	DESCRIPTION	BY	DATE

HOWARD J. BARTH & ASSOCIATES, INC.

CONSULTING ENGINEERS

347 E. WASHINGTON STREET
GREENSBURG, INDIANA 47240
812-663-2177 FAX 812/663-7906

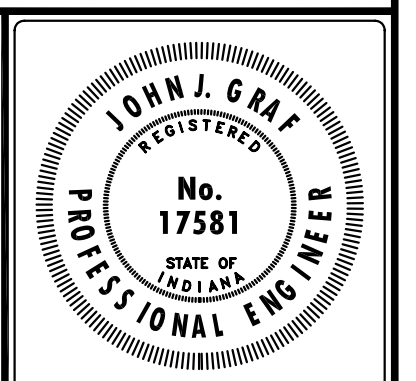

SHEET NUMBER
6