


HOLEY MOLEY SAYS
"DON'T DIG BLIND"
 CALL TOLL FREE
 1-800-382-5544
CALL 2 WORKING DAYS BEFORE YOU DIG

UTILITY NOTES:
 CONTRACTOR TO NOTIFY INDIANA UNDERGROUND PLANT PROTECTION CENTER (HOLEY MOLEY) @ 1-800-382-5544, MINIMUM 2 WORKING DAYS PRIOR TO THE START OF CONSTRUCTION AND REQUEST THE LOCATION OF ALL UTILITIES TO BE PROTECTED AND MARKED. THE CONTRACTOR SHALL BE RESPONSIBLE FOR CONDUCTING NON-DESTRUCTIVE UTILITIES.
 UTILITY COLOR CODES:
 RED - ELECTRIC
 YELLOW - GAS, OIL, PETROLEUM PRODUCTS
 ORANGE - COMMUNICATIONS, TELEPHONE, CABLE, FIBER
 BLUE - WATER, SEWER, & TRAFFIC SIGNALS
 GREEN - SEWERS
 WHITE - PROPOSED EXCAVATION

THE LOCATIONS OF UNDERGROUND UTILITIES AS SHOWN HEREIN HAVE BEEN DETERMINED FROM INFORMATION PROVIDED BY OTHERS. NEITHER THE OWNER NOR ENGINEER ASSUME RESPONSIBILITY FOR THE ACCURACY OF INFORMATION PROVIDED BY OTHERS.
 SEE APPENDIX OF SPECIFICATIONS FOR STANDARD DETAILS.
 SANITARY SEWER LINES TO BE LOCATED NO CLOSER THAN 10 FEET HORIZONTAL AND 1.5 FEET VERTICAL FROM WATER LINES.
 CONTRACTOR RESPONSIBLE TO MAINTAIN EXISTING UTILITIES. ANY UTILITIES DAMAGED BY CONTRACTOR TO BE REPLACED AT NO COST TO OWNER.
 INSTALL ALL SERVICE MATERIALS TO THE RIGHT OF ANY PARROT WATER AND SWITZERLAND NATIONAL GAS SHALL BE NOTIFIED OF WORK AT 1-812-94-2243 AND 1-812-427-3333 RESPECTIVELY

PLAN

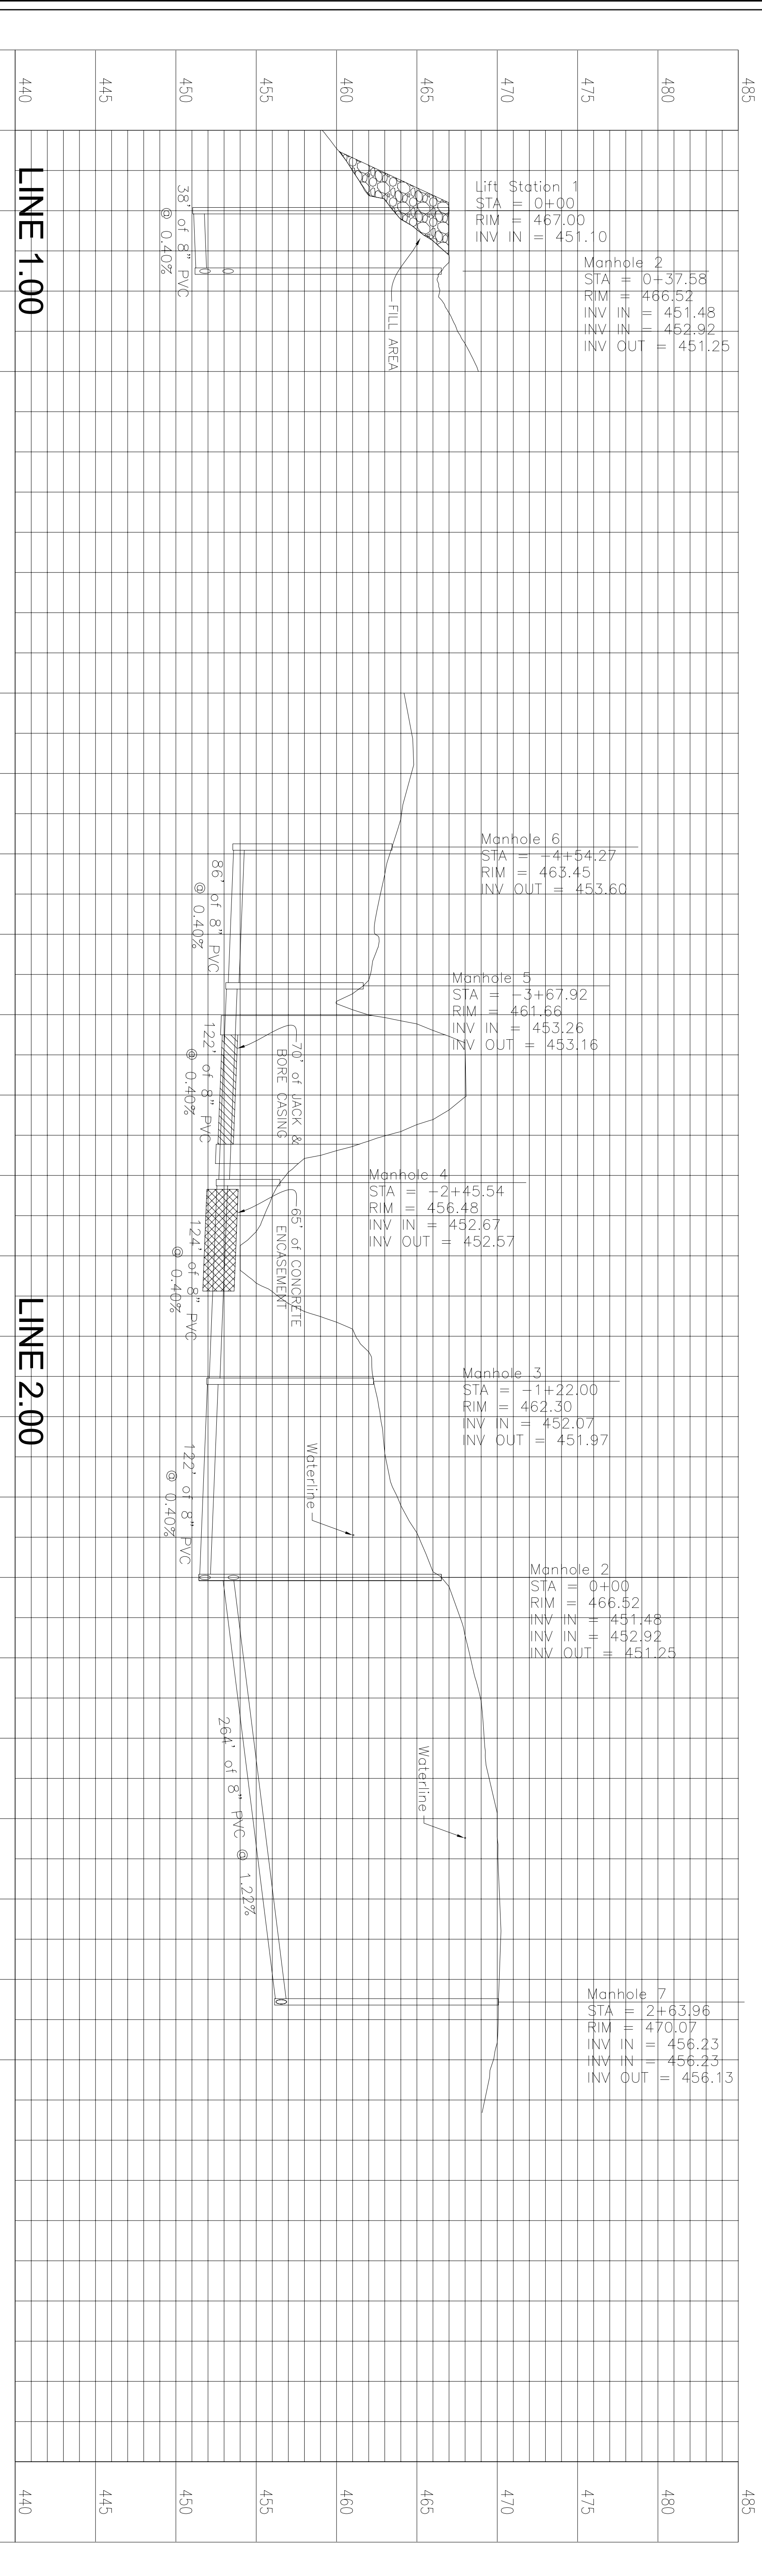

PROFILE

485									
480									
475									
470									
465									
460									
455									
450									
445									
440									

485									
480									
475									
470									
465									
460									
455									
450									
445									
440									

PROFILE

SCALE
 1"=50' Hor
 1"=5' Ver

RECORD DRAWINGS
 These Record documents have been prepared based on information provided by others. The Design Professional has not verified the accuracy and/or completeness of this information and shall not be responsible for any errors or omissions which may be incorporated herein as a result.

<p>PLAN & PROFILE LINE 1.00 & 2.00</p> <p>FLORENCE REGIONAL SEWER DISTRICT SWITZERLAND CO., INDIANA</p>	<p>JOB NO 2760 DWN BY JCE CHK BY JJC DATE 3/02 SCALE 1:50</p>	<p>1 Revised Lift Station Location, added street names 2 Changed Invert Elevation on MH 5 & % Slope of Pipe from MH 2 to MH 7 (Profile). Corrected Station of Manhole 5 (Plan), Added Section, Twp. & Rng. information.</p>	<p>ice 3/02 dis 6/10/04</p>	<p>HOWARD J. BARTH & ASSOCIATES, INC. CONSULTING ENGINEERS</p> <p>347 E. WASHINGTON STREET GREENSBURG, INDIANA 47240 812-663-2177 FAX 812-663-7906</p>	<p>RECORD DRAWINGS MAY 2005</p>						
	<p>1"=50' Hor 1"=5' Ver</p>	<p>© copyright 2002</p>	<p>REVISIONS</p> <table border="1"> <tr> <th>NO</th> <th>DESCRIPTION</th> <th>BY</th> <th>DATE</th> </tr> <tr> <td> </td> <td> </td> <td> </td> <td> </td> </tr> </table>	NO	DESCRIPTION	BY	DATE				
NO	DESCRIPTION	BY	DATE								