


HOLEY MOLEY SAYS
 "DON'T
 DIG
 BLIND"
 CALL TOLL FREE
 1.800.382.5844
 CALL TOLL FREE
 CALL TOLL FREE
 CALL 2 WORKING DAYS BEFORE YOU DIG

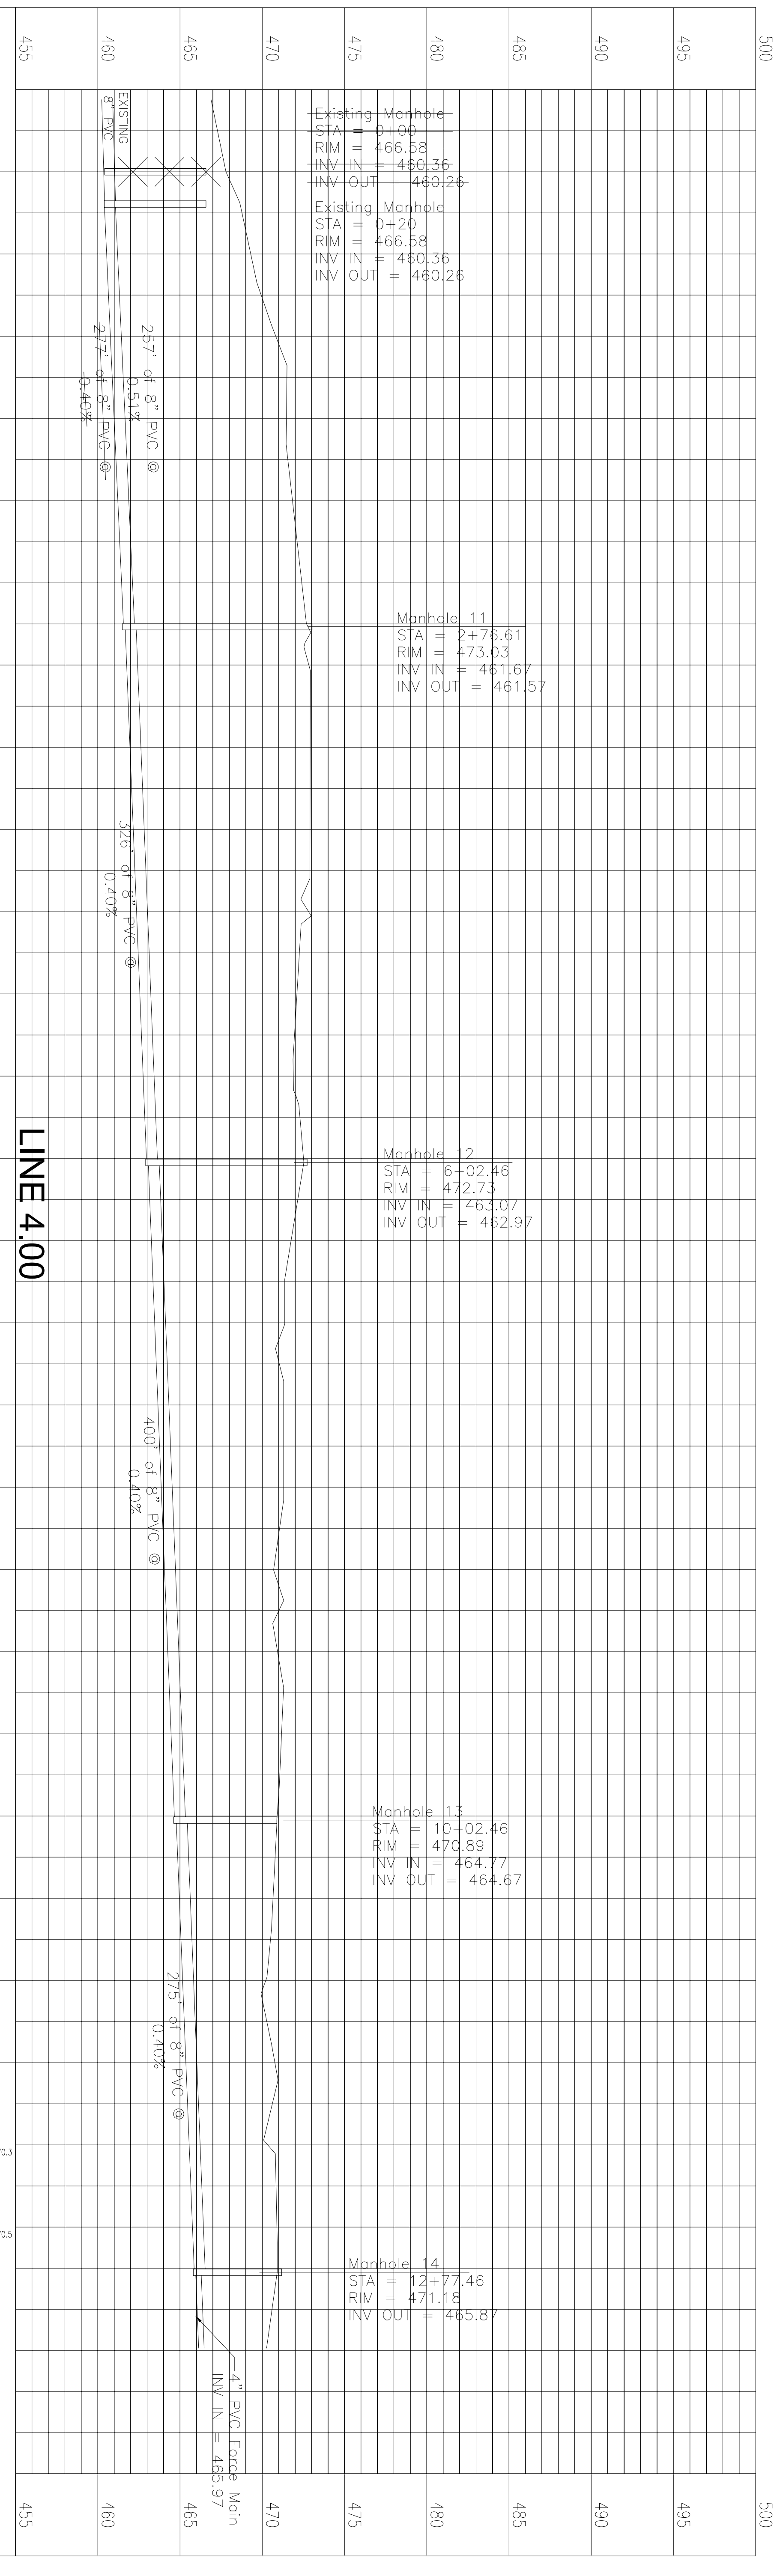

PROFILE

LINE 4.00

RECORD DRAWINGS
 These Record documents have been prepared based on information provided by others. The Design Professional has not verified the accuracy and/or completeness of this information and shall not be responsible for any errors or omissions which may be incorporated herein as a result.

PLAN & PROFILE
LINE 4.00
 FLORENCE REGIONAL SEWER DISTRICT
 SWITZERLAND CO., INDIANA

JOB NO 2769
 DWN BY JCE
 CHK BY JJG
 DATE 3/02
 SCALE 1:50

NO	DESCRIPTION	BY	DATE
1	Added street names	jce	9/02
2	Corrected Invert Elevations in Plan View	dis	6/10/04
3	Modified Invert Elevations	jce	10/05/04

HOWARD J. BARTH & ASSOCIATES, INC.
 CONSULTING ENGINEERS
 347 E. WASHINGTON STREET
 GREENSBURG, INDIANA 47240
 812-663-2177 FAX 812-663-7906

RECORD DRAWINGS
 MAY 2005